



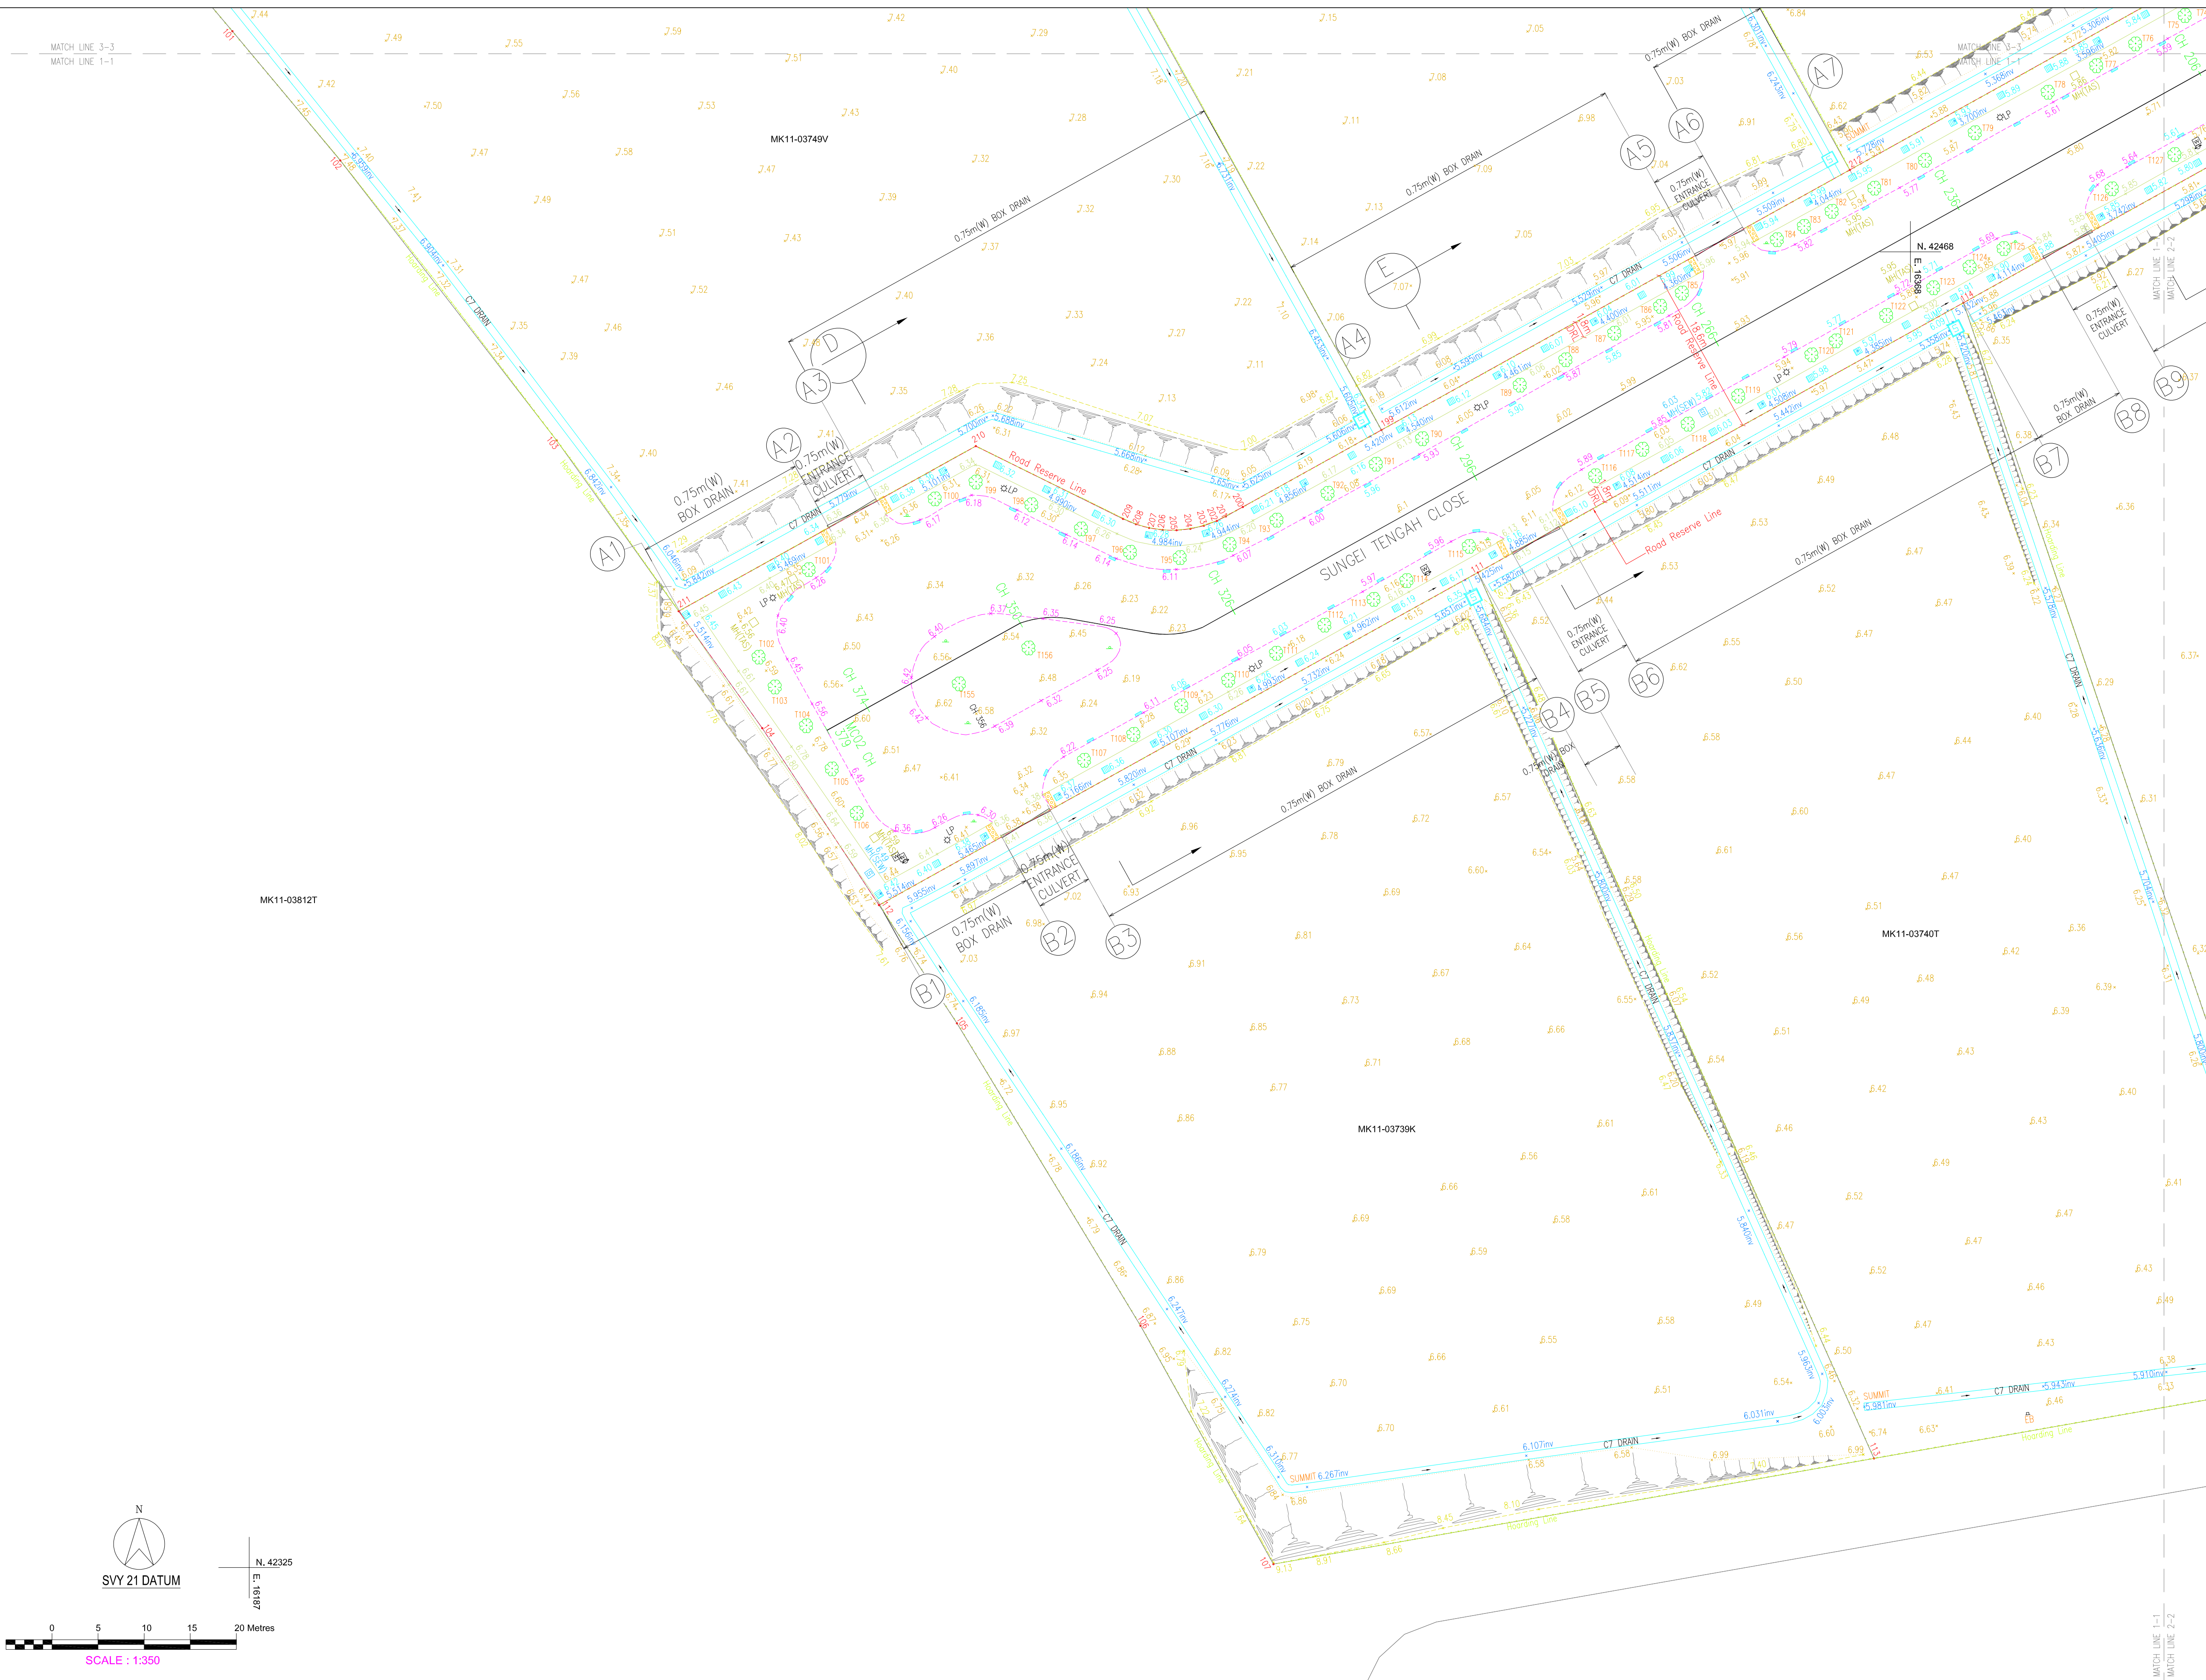

- NOTE :
1. Co-ordinates system is on SVY21 Datum.
 2. Road Reserve Line adopted from Govt. RLP, PO: P568808B7_2 purchased on 21/01/2020.
 3. Boundary / Road Reserve Line shown hereon are provisional and subject to alteration on final survey.
 4. Level Datum is on SHD=0.000m. Initial bench mark adopted is VCPB0353, R.L.=14.617m, located along JALAN TAPISAN/JALAN LEKAR near LP23.
 5. For cross sections, refer to Dwg No. CAK/20/7483/ASB/CS 1
 6. For longitudinal sections, refer to Dwg No. CAK/20/7483/ASB/LS 1 to 3
 7. For tree information, refer to Dwg No. CAK/20/7483/TREE
 8. All dimensions shown hereon are in metres unless otherwise stated
 9. All information shown hereon are correct as on 12/02/2021
 10. Any apparent encroachment must be investigated with independent survey. For legal actions, a cadastral survey plan in SVY21 approved by the Chief Surveyor of Singapore Land Authority shall be required.

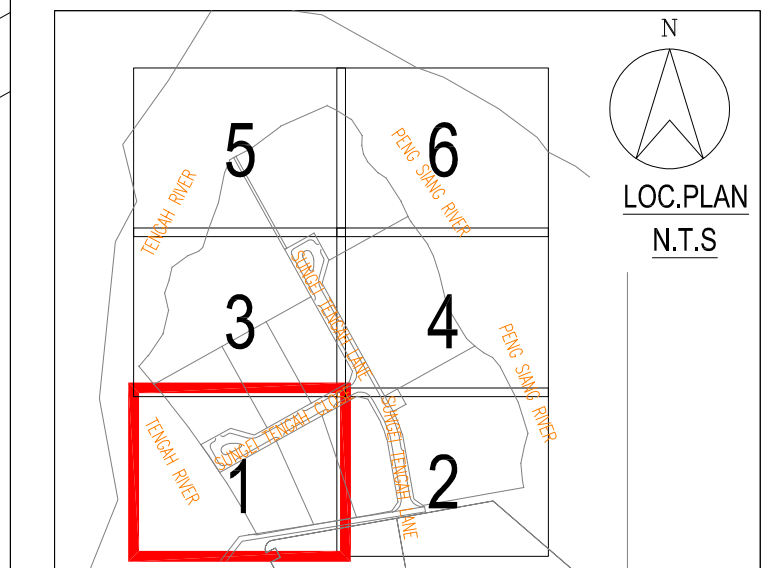

- LEGEND:
- | | | | |
|-----------|--------------------|---|-------------------|
| ● B | Bollard | ✱ | Coconut Tree |
| ⬢ EB | Electric Box | ⬢ | Palm Tree |
| □ MHE | Electrical Manhole | ⬢ | Tree |
| □ IC | Inspection Chamber | ⬢ | Gate |
| ⬢ IG | Iron Grating | ⬢ | Fence |
| ⬢ LP | Lamppost | ⬢ | Hoarding |
| ⬢ MH(PUB) | MH(PUB) | ⬢ | Guardrail |
| ⬢ RS | Road Sign | ⬢ | Rolling |
| ⬢ MH(SEW) | Sew Manhole | ⬢ | Gas Pipe Line |
| ⬢ SB | Sign Board | ⬢ | Cable Line |
| ⬢ SH | Sign Board(BIG) | ⬢ | Road Reserve Line |
| ⬢ Sump | Sump | ⬢ | Boundary |
| ⬢ WV | Water Valve | | |
| ⬢ WEL | Well | | |

PROJECT TITLE:

**PROPOSED ROAD, DRAIN, SEWER,
MINOR DEMOLITION WORKS AND
ERECTION OF ONE 22KV/LT ESS AT
SUNGEI TENGAH ROAD**

DRAWING TITLE:

AS BUILT SURVEY PLAN


SURVEYOR:

CAK & FG SURVEY PTE LTD.
701 SIMS DRIVE #05-02 LHK BUILDING
SINGAPORE 387383
TEL: 62991775 FAX: 62991416


21/06/2021
CHIA AIK KOK, BEM
B. SURV./Q.LDI, F.S.I.S.V.
REGISTERED SURVEYOR C23
SINGAPORE

REV.	DESCRIPTION	DATE

SCALE : 1:350 (A1) DRAWN BY : MIZI DATE : 26/01/2021
DRAWING NO : CAK/20/7483/A 001 SHEET : 1 OF 6

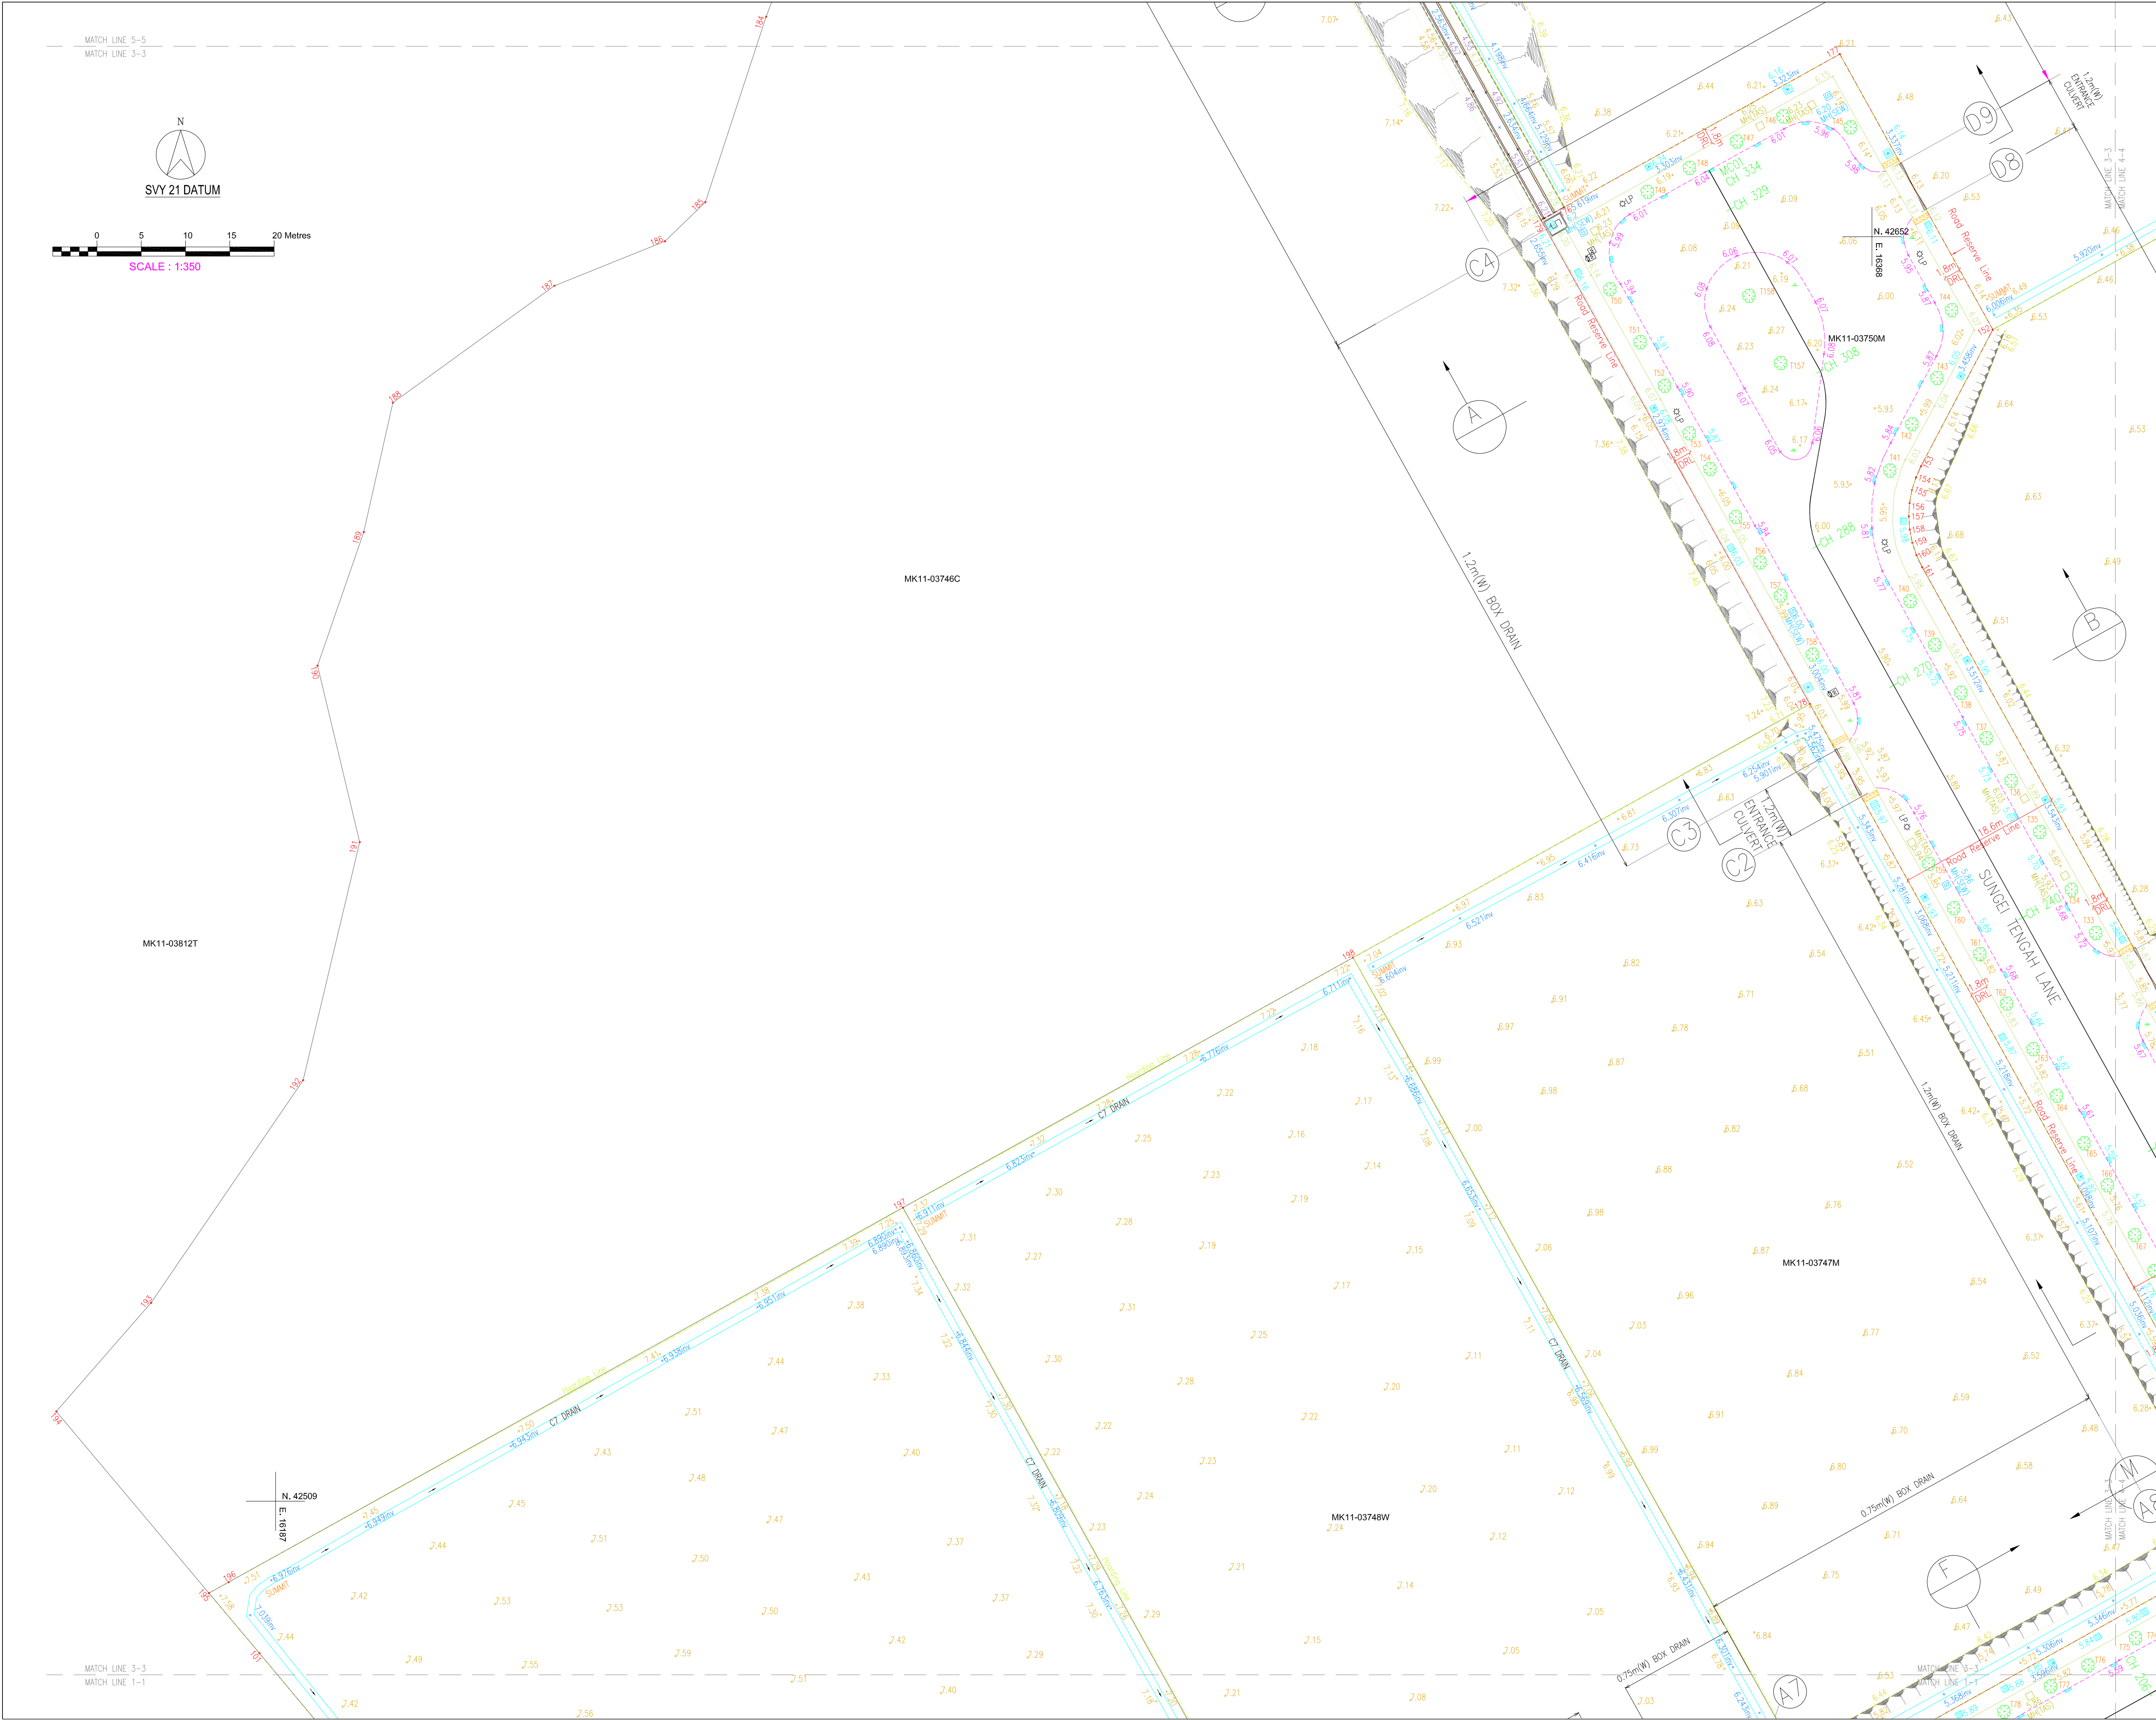

- NOTE :
1. Co-ordinates system is on SVY21 Datum.
 2. Road Reserve Line adopted from Govt. RLP, PO: P568808BT_2 purchased on 21/01/2020.
 3. Boundary / Road Reserve Line shown hereon are provisional and subject to alteration on final survey
 4. Level Datum is on SHD=0.000m, Initial bench mark adopted is VCP80353, RL=14.617m, located along JALAN TAPISANJALAN LEKAR near LP23.
 5. For cross sections, refer to Dwg No. CAK/20/7483/ASB/CS 1
 6. For longitudinal sections, refer to Dwg No. CAK/20/7483/ASB/LS 1 to 3
 7. For tree information, refer to Dwg No. CAK/20/7483/TREE
 8. All dimensions shown hereon are in metres unless otherwise stated
 9. All information shown hereon are correct as on 12/02/2021
 10. Any apparent encroachment must be investigated with independent survey. For legal actions, a cadastral survey plan in SVY21 approved by the Chief Surveyor of Singapore Land Authority shall be required.

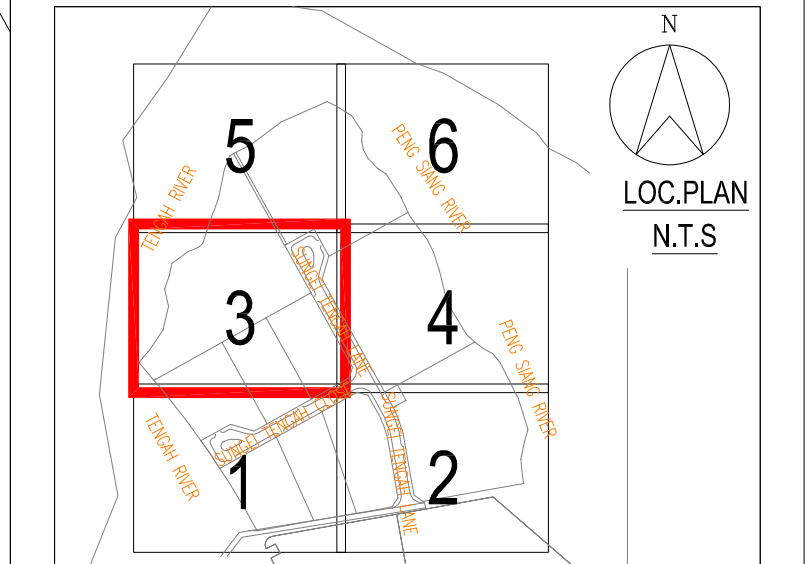

- LEGEND:
- | | | | |
|-----------|--------------------|---|-------------------|
| • B | Bollard | ✱ | Coconut Tree |
| □ EB | Electric Box | ✱ | Palm Tree |
| □ MHE | Electrical Manhole | ✱ | Tree |
| □ IC | Inspection Chamber | ✱ | Gate |
| □ IG | Iron Grating | ✱ | Fence |
| □ LP | Lampost | ✱ | Hoarding |
| □ MH(PUB) | MH(PUB) | ✱ | Guardrail |
| ✱ RS | Road Sign | ✱ | Rolling |
| □ MH(SEW) | Sew Manhole | ✱ | Gas Pipe Line |
| ✱ SB | Sign Board | ✱ | Cable Line |
| ✱ SH | Sign Board(Big) | ✱ | Road Reserve Line |
| □ Sump | Sump | ✱ | Boundary |
| ✱ WV | Water Valve | | |
| ○ WEL | Well | | |

PROJECT TITLE:

PROPOSED ROAD, DRAIN, SEWER, MINOR DEMOLITION WORKS AND ERECTION OF ONE 22KV/LT ESS AT SUNGEI TENGAH ROAD

DRAWING TITLE:

AS BUILT SURVEY PLAN


SURVEYOR:

CAK & FG SURVEY PTE LTD.
701 SIMS DRIVE #05-02 LHK BUILDING
SINGAPORE 387383
TEL: 62991775 FAX: 62991416


21/06/2021
CHIA AIK KOK, BSM
B. SURV./Q.LDI, F.S.A.S.V.,
REGISTERED SURVEYOR Q23
SINGAPORE

REV.	DESCRIPTION	DATE

SCALE : 1:350 (A1) DRAWN BY : MIZI DATE : 26/01/2021
DRAWING NO : CAK/20/7483/A 003 SHEET : 3 OF 6

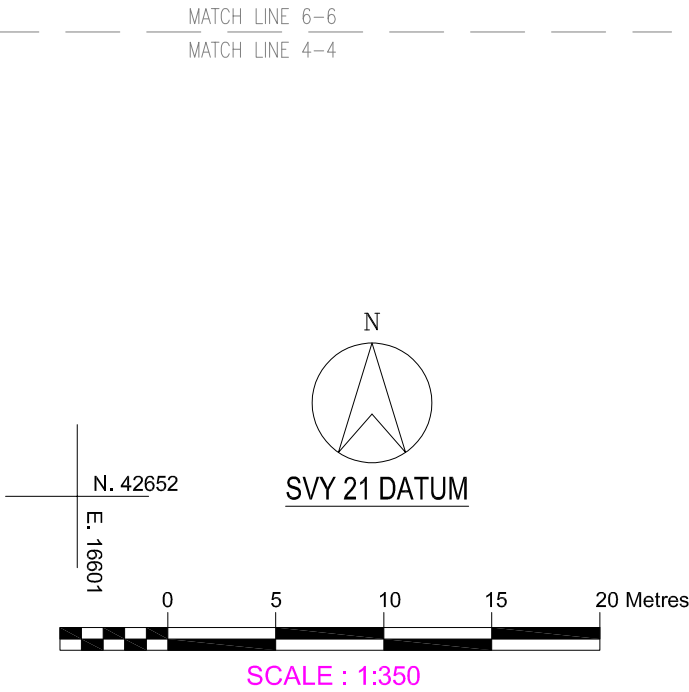

- NOTE :
1. Co-ordinates system is on SVY21 Datum.
 2. Road Reserve Line adopted from Govt. RLP, PO: P5688088T_2 purchased on 21/01/2020.
 3. Boundary / Road Reserve Line shown hereon are provisional and subject to alteration on final survey.
 4. Level Datum is on SHD+0.000m, Initial bench mark adopted is VCP80353, R.L.=14.617m, located along JALAN TAPISANJALAN LĒKAR near LP23.
 5. For cross sections, refer to Dwg No. CAK/20/7483/ASB/CS 1
 6. For longitudinal sections, refer to Dwg No. CAK/20/7483/ASB/LS 1 to 3
 7. For tree information, refer to Dwg No. CAK/20/7483/TREE
 8. All dimensions shown hereon are in metres unless otherwise stated
 9. All information shown hereon are correct as on 12/02/2021
 10. Any apparent encroachment must be investigated with independent survey. For legal actions, a cadastral survey plan in SVY21 approved by the Chief Surveyor of Singapore Land Authority shall be required.

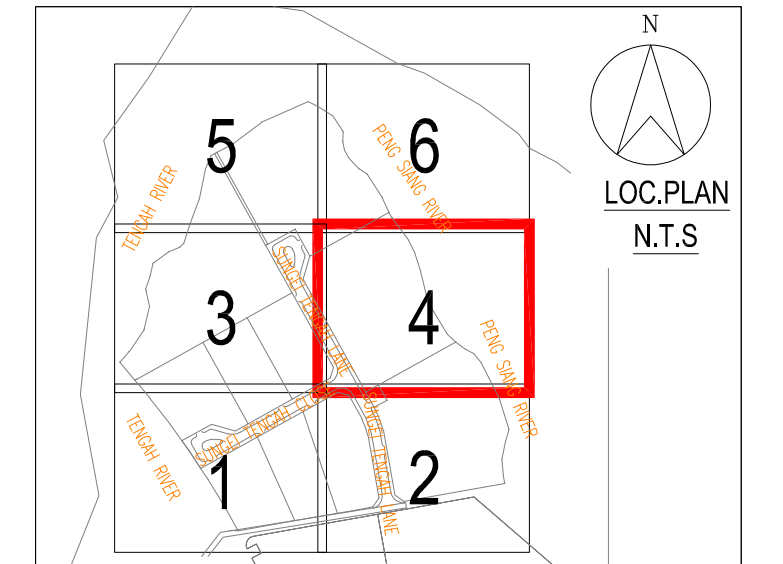

- LEGEND:
- | | | | |
|-----------|--------------------|---|-------------------|
| ● B | Bollard | ✳ | Coconut Tree |
| □ EB | Electric Box | ✳ | Palm Tree |
| □ MHE | Electrical Manhole | ✳ | Tree |
| □ IC | Inspection Chamber | ✳ | Gate |
| □ IG | Iron Grating | ✳ | Fence |
| □ LP | Lampost | ✳ | Hoarding |
| □ MH(PUB) | MH(PUB) | ✳ | Guardrail |
| ✳ RS | Road Sign | ✳ | Rolling |
| □ MH(SEW) | Sew Manhole | ✳ | Gas Pipe Line |
| ✳ SB | Sign Board | ✳ | Cable Line |
| ✳ SH | Sign Board(Big) | ✳ | Road Reserve Line |
| □ Sump | Sump | ✳ | Boundary |
| □ WV | Water Valve | | |
| ○ WEL | Well | | |

PROJECT TITLE:

**PROPOSED ROAD, DRAIN, SEWER,
MINOR DEMOLITION WORKS AND
ERECTION OF ONE 22KV/LT ESS AT
SUNGEI TENGAH ROAD**

DRAWING TITLE:

AS BUILT SURVEY PLAN

SURVEYOR:

CAK & FG SURVEY PTE LTD.
701 SIMS DRIVE #05-02 LHK BUILDING
SINGAPORE 387383
TEL: 62991775 FAX: 62991416

CHIA AIK KOK, BEM
B. SURV./Q.L.D., F.S.A.S.V.,
REGISTERED SURVEYOR 023
SINGAPORE

REV.	DESCRIPTION	DATE

SCALE : 1:350 (A1) DRAWN BY : MIZI DATE : 26/01/2021
DRAWING NO : CAK/20/7483/A 004 SHEET : 4 OF 6




MK11-03812T

MATCH LINE 5-5

MATCH LINE 6-6

N. 42836
E. 16368

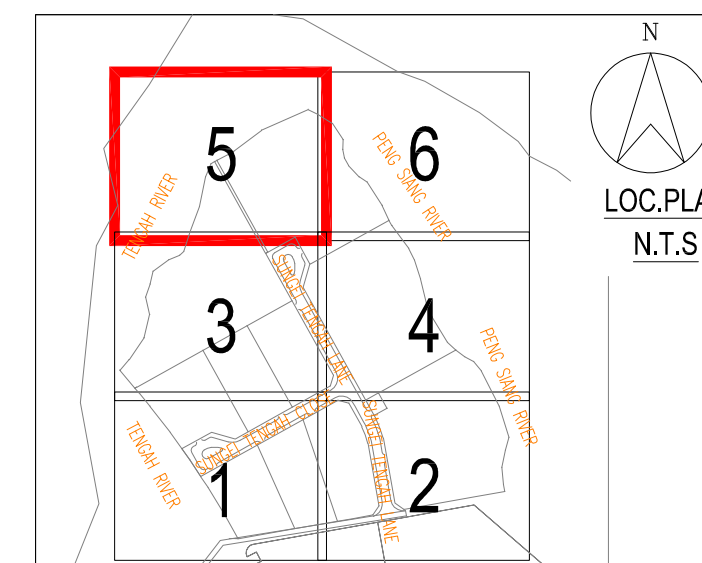

LEGEND:

- | | | | |
|---|--------------------|---|-------------------|
| ● B | Bollard |  | Coconut Tree |
| ■ EB | Electric Box |  | Palm Tree |
| □ MHE | Electrical Manhole |  | Tree |
| □ IC | Inspection Chamber |  | Gate |
|  IP | Iron Grating |  | Fence |
|  LP | Lamp Post |  | Hoarding |
| □ MH(PUB) | MH(PUB) |  | Guardrail |
| ■ RS | Road Sign |  | Railing |
|  MH(SEW) | Sew Manhole |  | Gas Pipe Line |
| ■ SB | Sign Board |  | Cable Line |
| ■ SH | Sign Board(BIG) |  | Road Reserve Line |
|  S | Sump |  | Roundabout |
|  W | Water Valve | | |
| ■ WL | Well | | |

PROJECT TITLE:

PROPOSED ROAD, DRAIN, SEWER,
MINOR DEMOLITION WORKS AND
ERECTION OF ONE 22KV/LT ESS AT
SUNGEI TENGAH ROAD

DRAWING TITLE:

AS BUILT SURVEY PLAN

SURVEYOR:



CAK & FG SURVEY PTE LTD.

701 SIMS DRIVE #05-02 LHK BUILDING
SINGAPORE 387383
TEL: 62991776 FAX: 62991416



21/06/202

HIA AIK KOK, 88

SURV.(QLD), F.S.I.S.V.
REGISTERED SURVEYOR OF

SINGAPORE


REV.	DESCRIPTION	DATE

SCALE : 1:350 (A1)	DRAWN BY : MIZI	DATE : 26/01/2021
--------------------	-----------------	-------------------

DRAWING NO : CAK/20/7483/A 005	SHEET : 5 OF 6
--------------------------------	----------------



1. Level Datum is on SHD=0.000m, Initial bench mark adopted is VCP80353, R.L.=14.617m, located along JALAN TAPISAN/JALAN LEKAR near LP23.
2. Position of longitudinal sections refer to Dwg No. CAK/20/7483/A 001 to 006
3. Structural details and dimensions are adopted from Consultant's drawing no. 005_191007_CS_LS01 to LS03
4. All information shown hereon are correct as on 11/02/2021

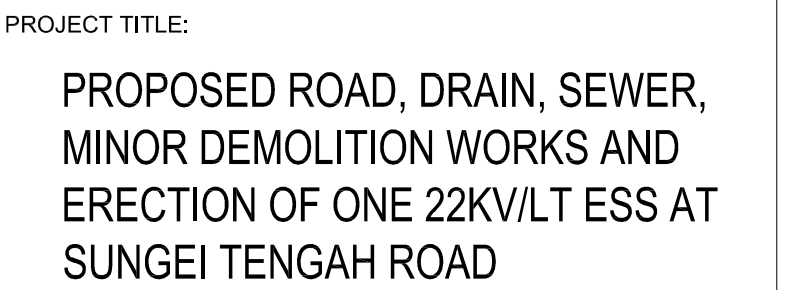

DRAWING TITLE:

AS - BUILT
LONGITUDINAL SECTION DRAWING

SURVEYOR:

 **CAK & FG SURVEY PTE LTD.**
701 SIMS DRIVE #05-02 LHK BUILDING
SINGAPORE 387383
TEL: 62991776 FAX: 62991416




CAK & FG SURVEY PTE LTD.
 701 SIMS DRIVE #05-02 LHK BUILDING
 SINGAPORE 387383
 TEL: 62991776 FAX: 62991416

21/06/2021
A AIK KOK, BMM
URV.(Q'LD), F.S.I.S.V.
STERED SURVEYOR 023
APDRE

REV.	DESCRIPTION	DATE

SCALE : AS SHOWN (A1)	DRAWN BY : MIZI	DATE : 01/03/2021
DRAWING NO : CAK/20/7483/ASB/LS 2		SHEET : 2 OF 3

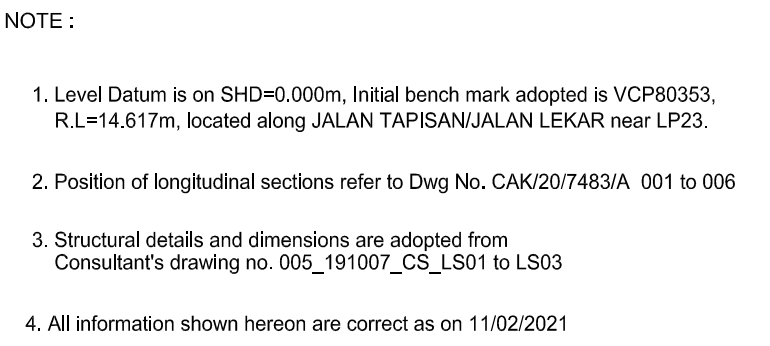

AS-BUILT ROAD CENTRE LINE	AS-BUILT ROAD EDGE LEVEL	AS-BUILT TOP/COPE LEVEL BOX / OPEN DRAIN / SUMP	AS-BUILT SOFFIT LEVEL OF DRAIN	AS-BUILT INVERT LEVEL OF DRAIN/CULVERT	CLEAR DEPTH OF BOX DRAIN	DRAIN CHAINAGE	ROAD CHAINAGE (MC01)
5.89	5.75	5.93	5.78	3.543	2.240	267.882	-
5.90	5.76	5.95	5.80	3.512	2.270	270.000	270.000
6.00	5.81	5.93	5.78	3.510	2.345	288.000	288.000
6.03	5.87	6.05	5.83	3.485	2.442	308.000	308.000
6.07	5.96	6.13	5.98	3.339	2.641	328.449	328.449
6.09	5.97	6.13	5.98	3.364	2.541	330.174	-
6.08	5.98	6.14	5.98	3.337	2.516	334.449	-
6.08	5.96	6.13	5.98	3.308	2.653	329.000	329.000
6.21	-	6.21	-	3.290	2.672	334.400	334.400
				2.635		385.050	385.050

SCALE : AS SHOWN (A1)	DRAWN BY : MIZI	DATE : 01/03/2021
DRAWING NO : CAK/20/7483/ASB/LS 3		SHEET : 3 OF 3

