



N41400
E16280

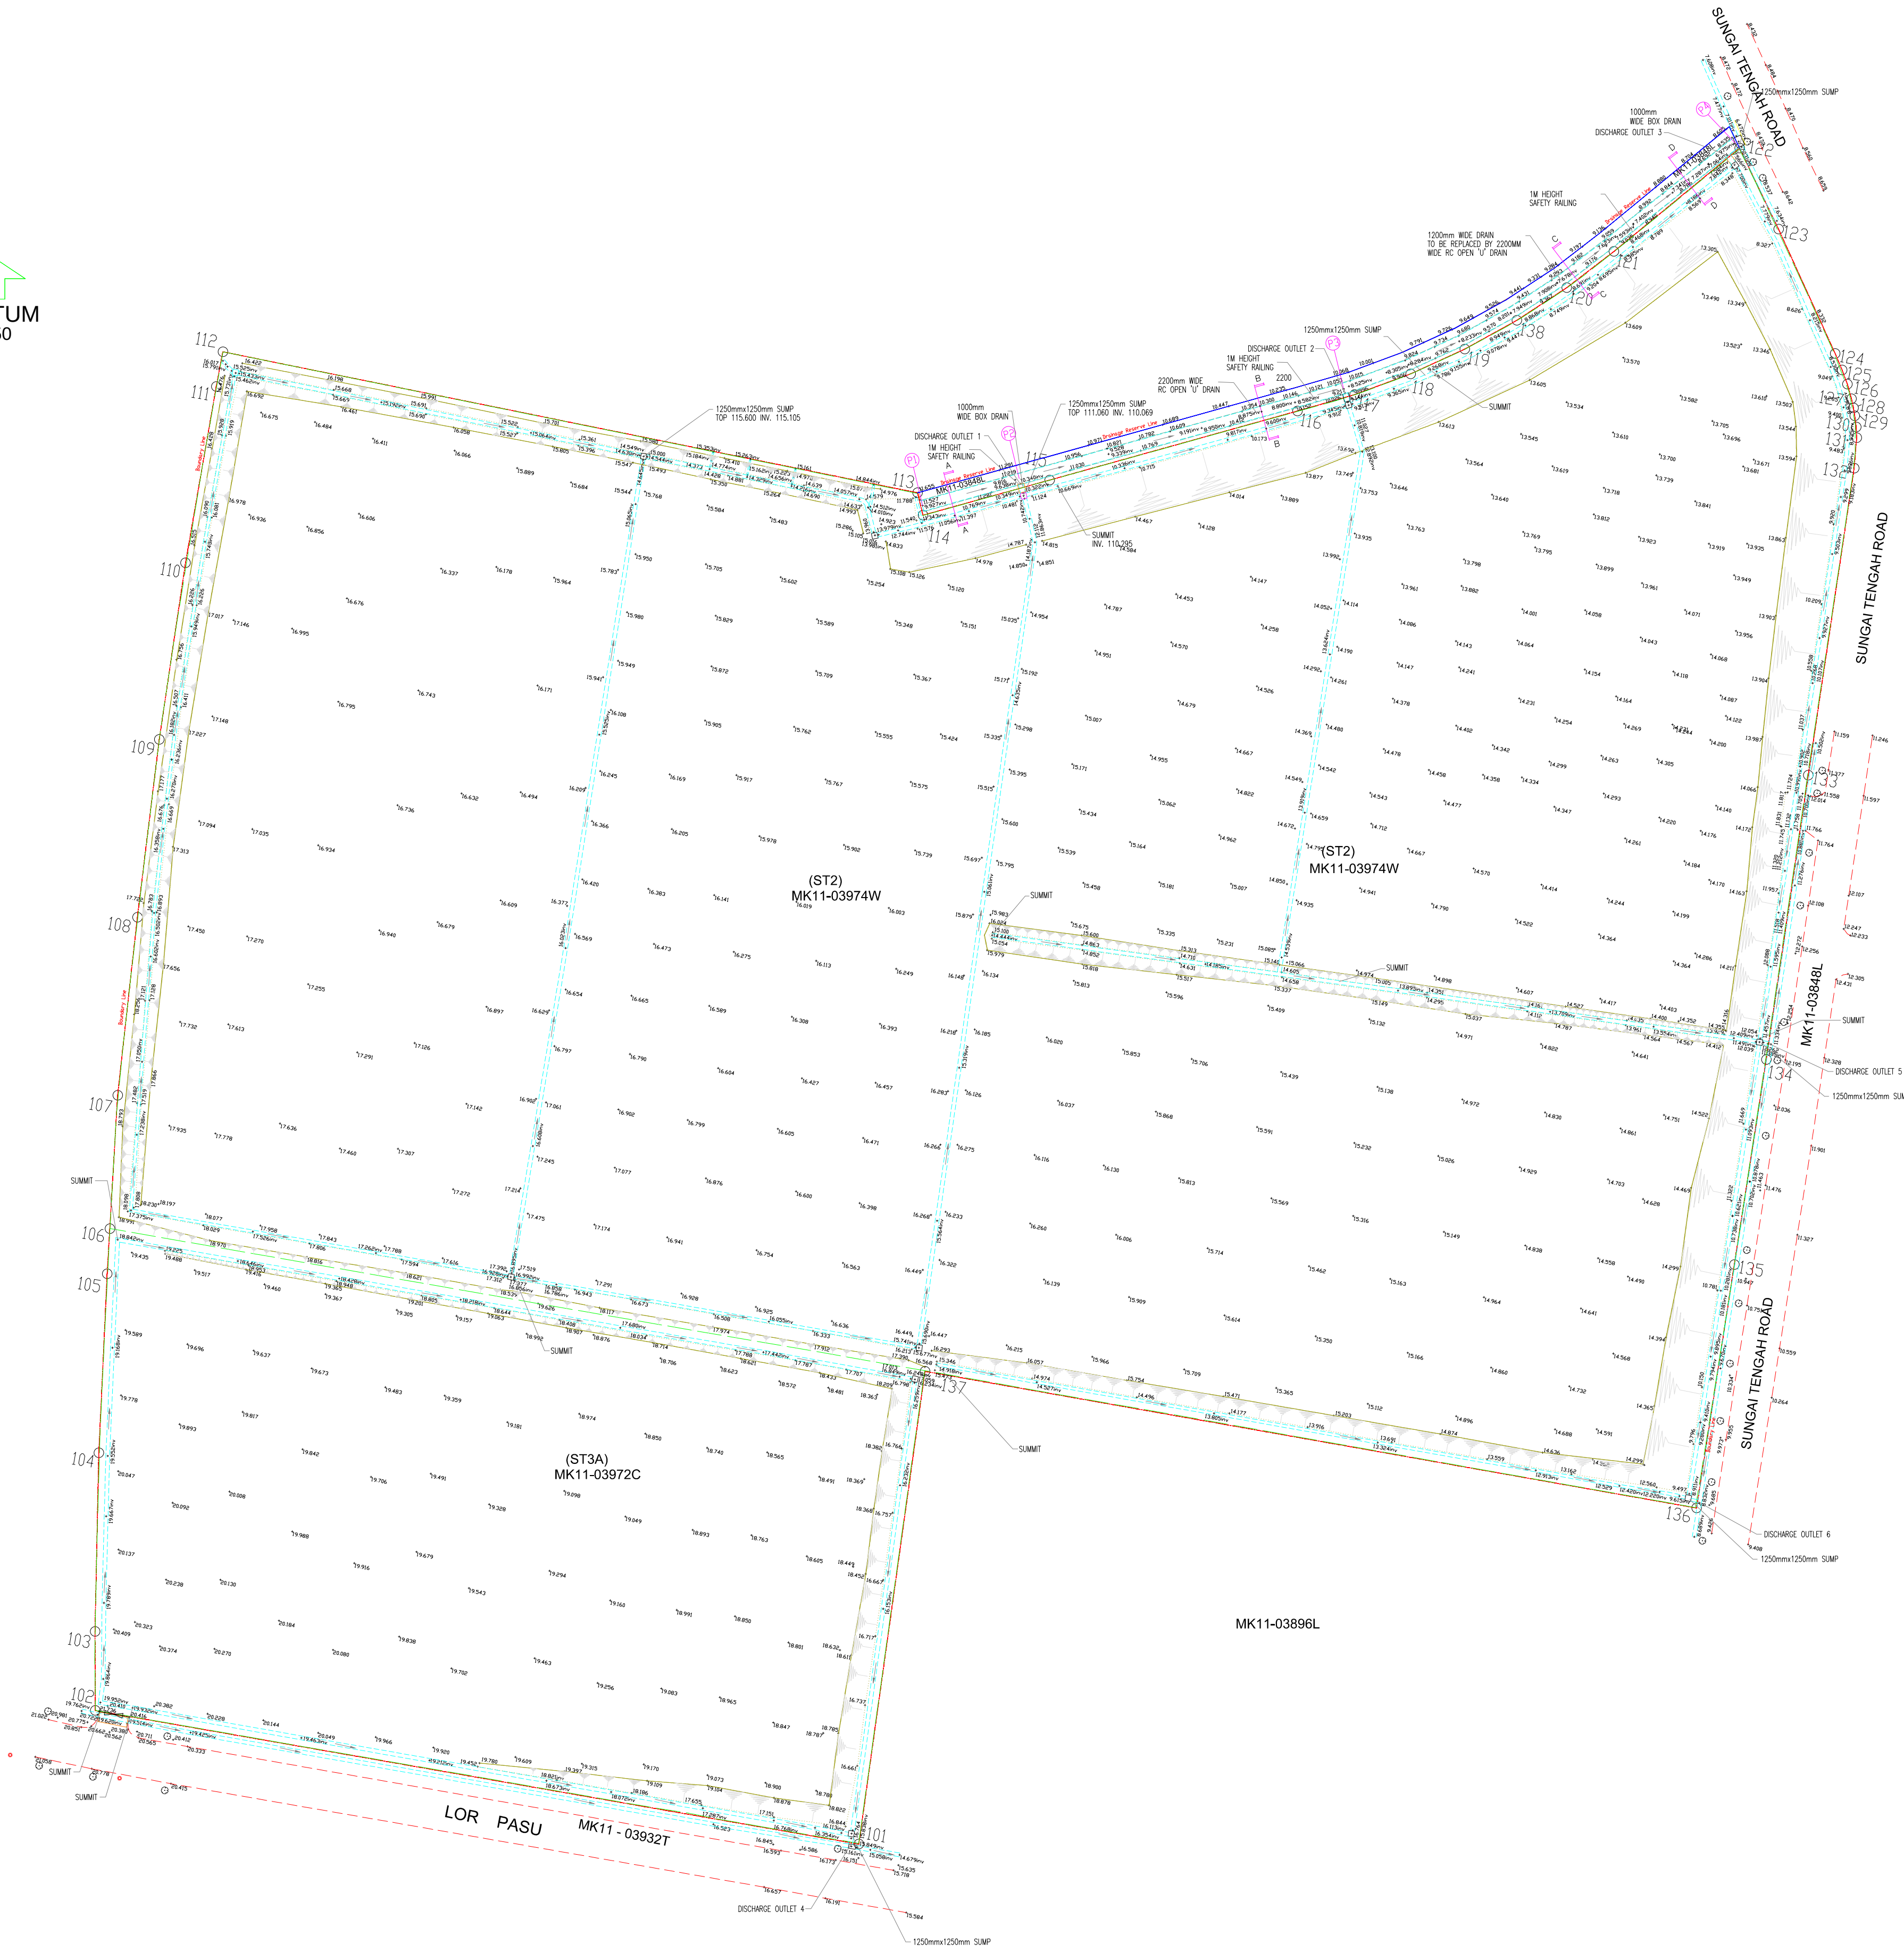

N40990
E16280

N41400
E16730

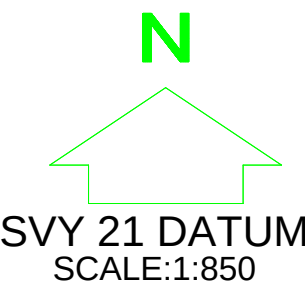

N40990
E16730

NOTE:

1. HORIZONTAL DATUM BASED ON SVY-21 DATUM
2. INITIAL LEVEL BASED ON GOVT.NO VCP80347=6.316m,

BOUNDARY CO ORDINATES BASE ON SVY21 DATUM		
BDY NO	NORTHING	EASTING
B1	41028.206	16479.209
B2	41056.004	16320.361
B3	41072.452	16320.298
B4	41109.641	16321.098
B5	41146.874	16322.835
B6	41156.267	16323.384
B7	41184.044	16325.009
B8	41221.058	16329.117
B9	41258.083	16333.671
B10	41294.836	16339.133
B11	41331.508	16345.534
B12	41338.747	16346.893
B13	41308.413	16491.402
B14	41304.743	16492.552
B15	41312.051	16518.912
B16	41326.419	16570.447
B17	41329.836	16582.362
B18	41334.138	16593.987
B19	41339.299	16605.254
B20	41345.290	16616.102
B21	41352.078	16626.467
B22	41359.624	16636.294
B23	41364.254	16670.559
B24	41338.386	16682.329
B25	41334.951	16683.780
B26	41331.955	16684.873
B27	41328.969	16685.731
B28	41327.062	16686.140
B29	41325.412	16686.396
B30	41323.086	16686.599
B31	41320.836	16686.806
B32	41314.504	16686.769
B33	41250.616	16676.724
B34	41191.459	16668.000
B35	41098.142	16653.502
B36	41126.590	16492.971
B37	41126.590	16492.971

LEGEND :

- Lamp Post
- Drainage Sump
- Drain grating cover
- Dropinlet
- Electrical Box
- Fire Hydrant
- Fence
- Rolling
- Gate
- Water Valve
- Sign Board
- Inspection Chamber
- Sewer Manhole
- Tree
- Top Slope
- Bottom Slope

Survey Company:



Endorsement:



Project Title :

DESIGN AND BUILD PROPOSED DRAIN AND EARTHWORK AT ST2 & ST3, SUNGEI TENGAH ROAD.

Drawing Title :

AS BUILT SURVEY PLAN

SCALE: 1:850	DRAWN BY: GUNA	SURVEYED BY: K.LINGGAM	DATE: 11.04.2023
Drawing No.: AS_LORONG PASU/34/004/A1/2022			REV. 0
CAD File Name : AS BUILT.DWG			Sheet 1 of 2 A1