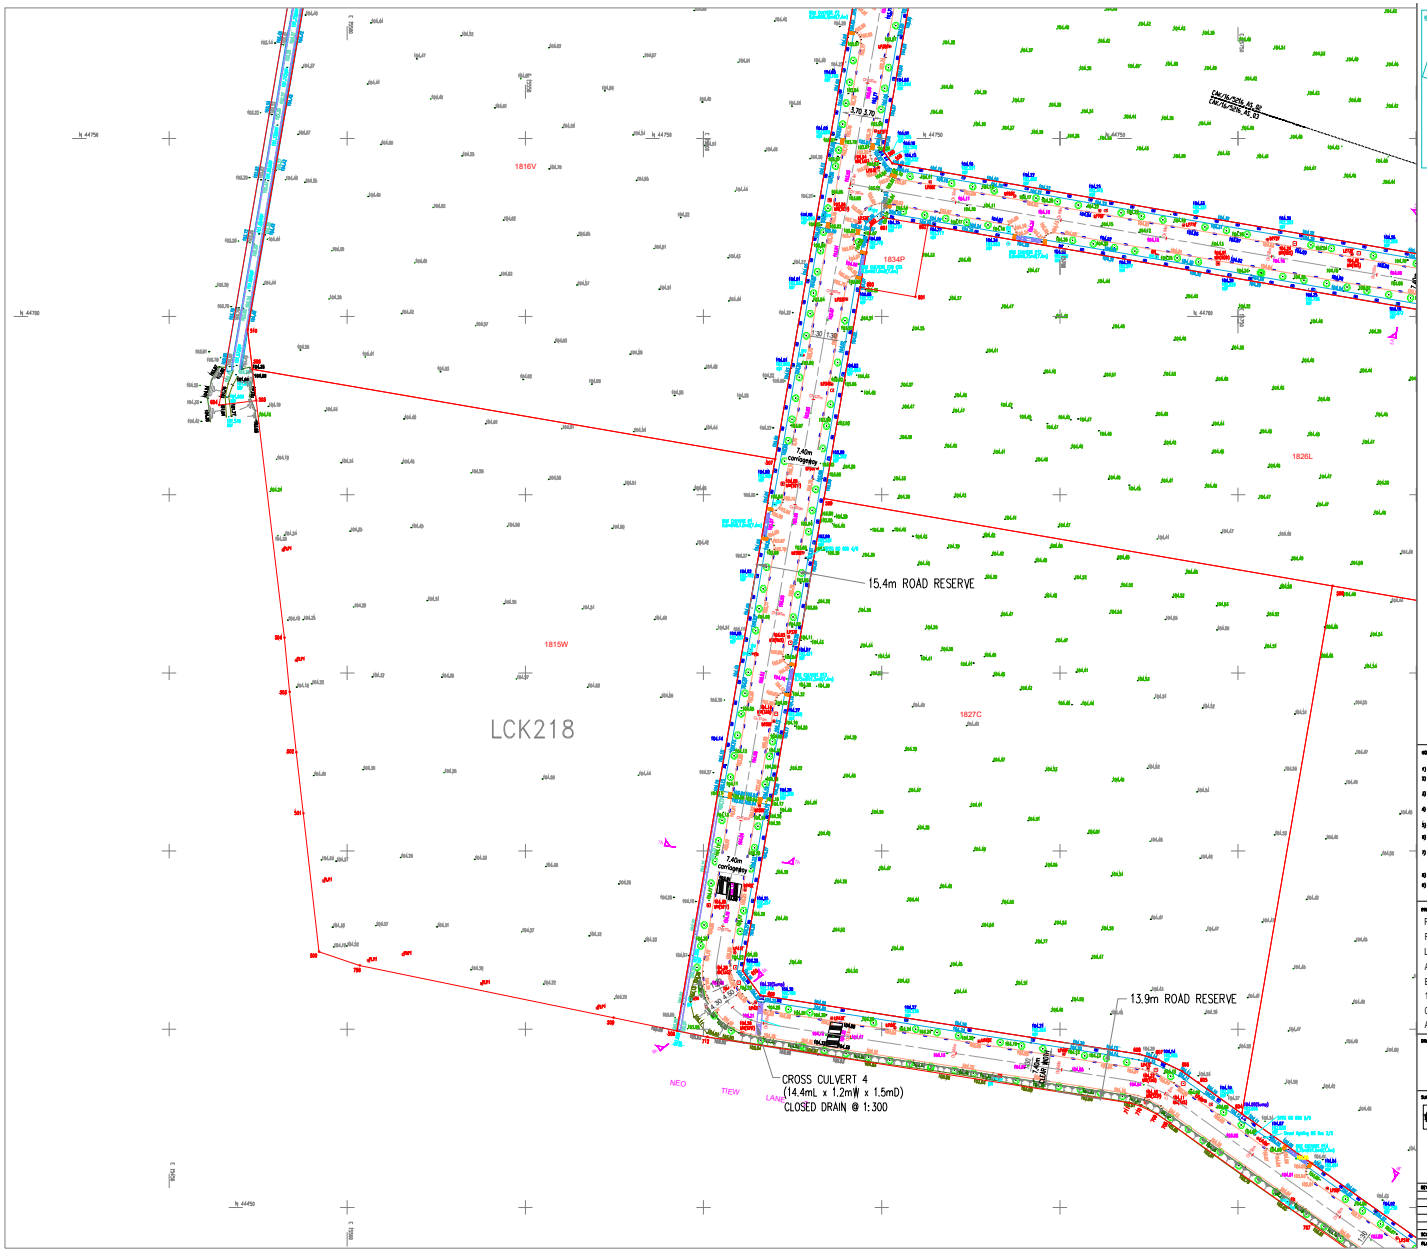


KEY PLAN

SURVEY AREA

SCALE : 1:500

NOTE :

1) Horizontal Datum is in SVY21 Datum.

2) Existing and Boundary coordinates adopted from Plan. Certified Plan No. 00000.

3) Boundary / Road Reserve line shown hereon are provisional and subject to alteration on final survey.

4) Water level based on Plan. TCC No. 00000, Datum mean Low Water Level 1 foot (0.3 m), 0.1124.000 hence as +00.+100m.

5) All dimensions shown hereon are in metre unless otherwise stated.

6) All Intersection shown hereon are correct as on 30.10.2012 and should be verified on site before commencement of work.

7) Any approved encroachment must be transferred with transparent surveys. Final setting a detailed survey plan is SVY21 approved by the Chief Surveyor of Singapore Land Authority shall be required.

8) For cross sections, refer to Plan No. CAK/FG/0216_AS_01.

9) For longitudinal sections, refer to Plan No. CAK/FG/0216_AS_02,03 to CAK/FG/0216_AS_02,04.

PROJECT TITLE

PROPOSED INFASTRUCTURE WORKS FOR THE PARCELLATION OF VACANT LAND INVOLVING ROAD PREPARATION AND ERECTION OF TWO 22KV/LT ELECTRICAL SUBSTATION ON LOTS 1677N PT, 1752N PT, 1624V PT, 0144M PT AND 1376T PT, MK 12 AT NEO TIEW ROAD / TURUT TRACK

DRAWING TITLE

AS-BUILT TOPOGRAPHICAL SURVEY PLAN

SURVEYOR

CAK & FG SURVEY PTE LTD.
701 SING DRIVE #03-02 LIM BUILDING
SINGAPORE 387203
TEL: 62991775 FAX: 62991414

CHUA AIK KIDK.
B. SURV.(Q.S.), P.S.M.S.
REGISTERED SURVEYOR
SINGAPORE

| REV. | DESCRIPTION | DATE |
|---|---|---|
| | | |

SCALE : 1:500 (A3) DRAWN BY : GB

PLAN NO : CAK/FG/0216_AS_03 DATE : 4-08-2016